


PLAT OF SURVEY

LOTS 3 AND 4 IN LANE'S STANTON POINT SUBDIVISION, BEING A SUBDIVISION OF OF THE SOUTHEAST FRACTIONAL QUARTER OF FRACTIONAL SECTION 2 AND THE SOUTHWEST FRACTIONAL QUARTER OF SECTION 2, TOWNSHIP 45 NORTH, RANGE 9 EAST OF THE THIRD PRINCIPAL MERIDIAN ACCORDING TO THE PLAT THEREOF RECORDED NOVEMBER 11, 1912, AS DOCUMENT 140485, IN LAKE COUNTY, ILLINOIS.

COMMONLY KNOWN AS: 37326 N. STANTON POINT ROAD
 P.I.N. 05-02-401-015
 AREA = 0.30 ACRES

NOTE: BASE FLOOD PLAIN ELEV.=741.6
 AVERAGE WATER LEVEL 737.0

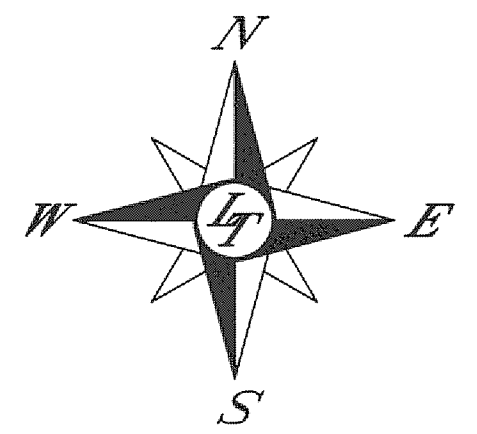

BASIS FOR BEARINGS:
 THE BASIS FOR BEARINGS SHOWN HEREON IS THE "PLAT OF GRANT OF EASEMENT" RECORDED MARCH 15, 2005 AS DOCUMENT NUMBER 5749275, IN LAKE COUNTY, ILLINOIS.

SCALE:
1"=20'

- NOTES:
1. THERE MAY BE UNDERGROUND UTILITIES THAT ARE NOT SHOWN HEREON.
 2. UNLESS OTHERWISE NOTED, ONLY THOSE EASEMENTS AND SETBACK LINES THAT ARE INDICATED ON THE RECORDED SUBDIVISION PLAT AND THAT AFFECT THE SUBJECT PARCEL ARE SHOWN HEREON.
 3. COMPARE ALL POINTS BEFORE BUILDING AND REPORT ANY DIFFERENCE AT ONCE.
 4. NO DIMENSIONS ARE TO BE ASSUMED BY SCALE MEASUREMENTS.
 5. THIS PLAT OF SURVEY IS VOID WITHOUT THE SEAL AND ORIGINAL SIGNATURE OF THE SURVEYOR.
 6. TIES ARE MEASURED TO AND ALONG THE FACE OF THE FENCE AT WAIST HEIGHT.
 7. MISSING LOT CORNERS NOT SET PER CLIENT REQUEST

RESIDENTIAL/COMMERCIAL/INDUSTRIAL
 CIVIL ENGINEERING AND
 SURVEYING SERVICES



3922 W. MAIN STREET
 McHENRY, IL. 60050
 P: (815)363-9200
 F: (815)363-9223
 E: LANDTECH@LAND
 TECHNOLOGYINC.COM

ILLINOIS PROFESSIONAL DESIGN FIRM
 No. 184-001331

LEGEND

- = FOUND MONUMENTATION
- T/F = TOP OF FOUNDATION
- (M) = MEASURED DIMENSION
- (R) = RECORD DIMENSION

THIS DRAWING IS PROTECTED BY COPYRIGHT REGULATIONS. THE INFORMATION SHOWN MAY NOT, IN WHOLE OR PART, BE REPRODUCED WITHOUT THE WRITTEN CONSENT OF:
 LAND TECHNOLOGY, INC.
 3922 W. MAIN STREET
 McHENRY, ILLINOIS, 60050
 ALL LEGAL RIGHTS RESERVED.

CLIENT:

TOM DUFF

DRAWN BY: SSG

CHK'D BY: JJB

DATE: 10/21/08

I:\08\08221\FINAL 10-20-08.dwg


FINAL SURVEY:
LOTS 3 AND 4
 LANE'S STANTON POINT
 SUBDIVISION
 SEC.'S 1&2. T45N. R9E

PAGE 1 OF 1

DRAWING NUMBER:
08-221

| LINE LEGEND | |
|-------------|---------------------------|
| —x—x—x— | = WOOD FENCE |
| —E— | = BURIED ELECTRIC LINE |
| —G— | = BURIED GAS LINE |
| —TV— | = BURIED TELEVISION CABLE |

| SYMBOL LEGEND | |
|---------------|--------------------|
| ⊙ | SANITARY MANHOLE |
| ⊕ | SANITARY CLEAN-OUT |
| ⊕ | WELL |
| ⊕ | AIR CONDITIONER |
| ⊕ | ELECTRIC METER |
| ⊕ | GAS METER |
| ⊕ | UTILITY BOX |

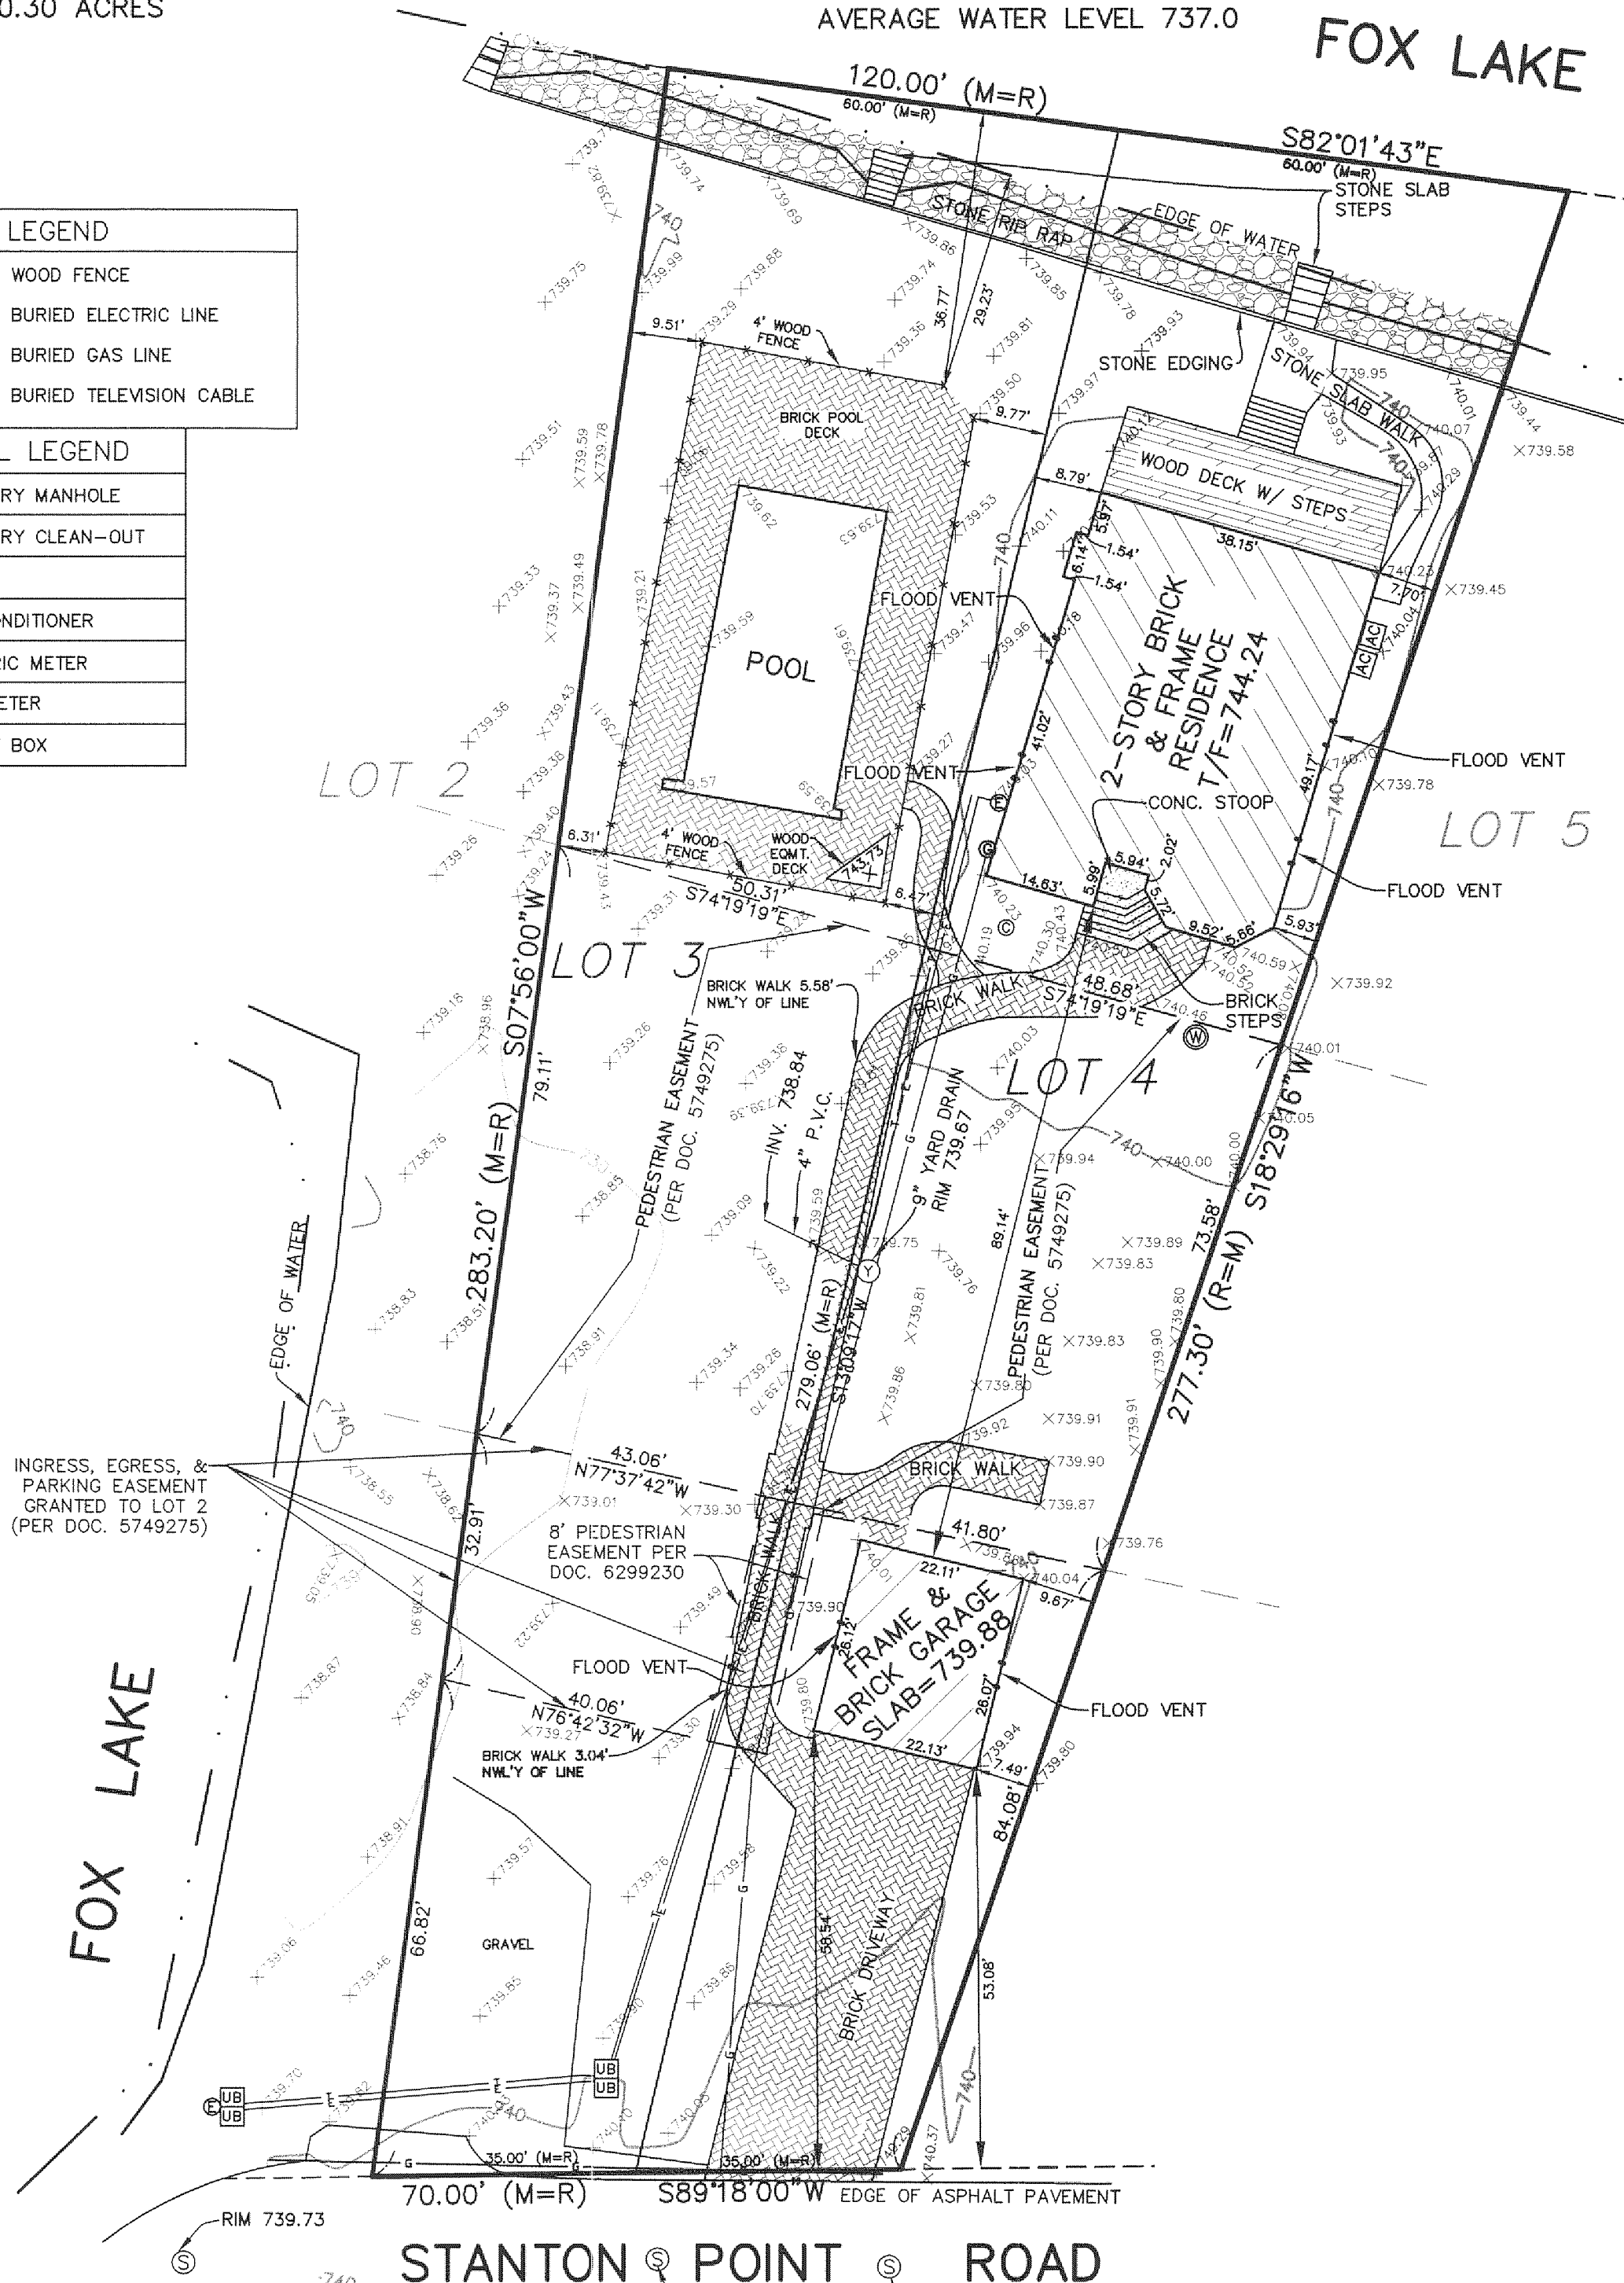


ALL LOT DIMENSIONS ARE RECORD UNLESS OTHERWISE NOTED.
 FIELD WORK COMPLETED 10/20/08.
 STATE OF ILLINOIS }
 COUNTY OF McHENRY } S.S.

THIS PROFESSIONAL SERVICE CONFORMS TO THE CURRENT ILLINOIS MINIMUM STANDARDS FOR A BOUNDARY SURVEY. DIMENSIONS ARE SHOWN IN FEET AND DECIMAL PARTS THEREOF.

I, JEFFERSON J. BRAZAS, AN ILLINOIS PROFESSIONAL LAND SURVEYOR, HEREBY CERTIFY THAT A SURVEY HAS BEEN MADE UNDER MY DIRECTION AND SUPERVISION OF THE PROPERTY DESCRIBED ABOVE, AND THAT THE PLAT HEREON DRAWN IS A CORRECT REPRESENTATION OF SAID SURVEY.

DATED THIS 21ST DAY OF OCTOBER, A.D., 2008.

JEFFERSON J. BRAZAS ILLINOIS PROFESSIONAL LAND SURVEYOR 35-3538
 LAND TECHNOLOGY INC., ILLINOIS PROFESSIONAL DESIGN FIRM

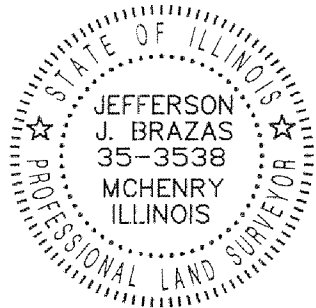

"B.M." BENCH-TIE IN E. FACE OF 26" TREE
 ELEV.=741.98

NOTE: BUILDING TIE DIMENSIONS SHOULD NOT BE USED TO DETERMINE LOT LINE LOCATIONS. REFER TO ACTUAL LOT CORNERS AND REPORT ANY DIFFERENCES TO THE SURVEYOR IMMEDIATELY.